

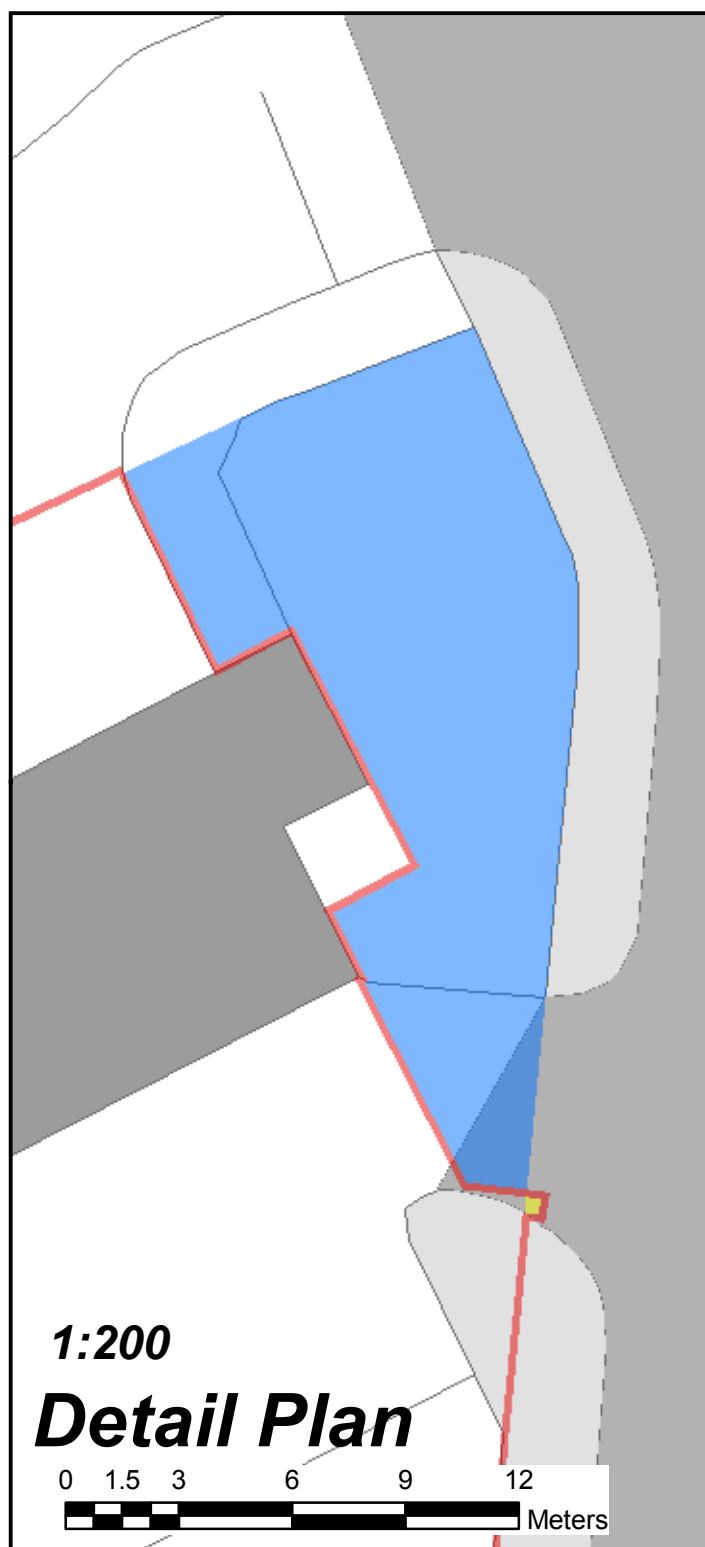 


Peel

Red Line Plan Boundary Adjustment

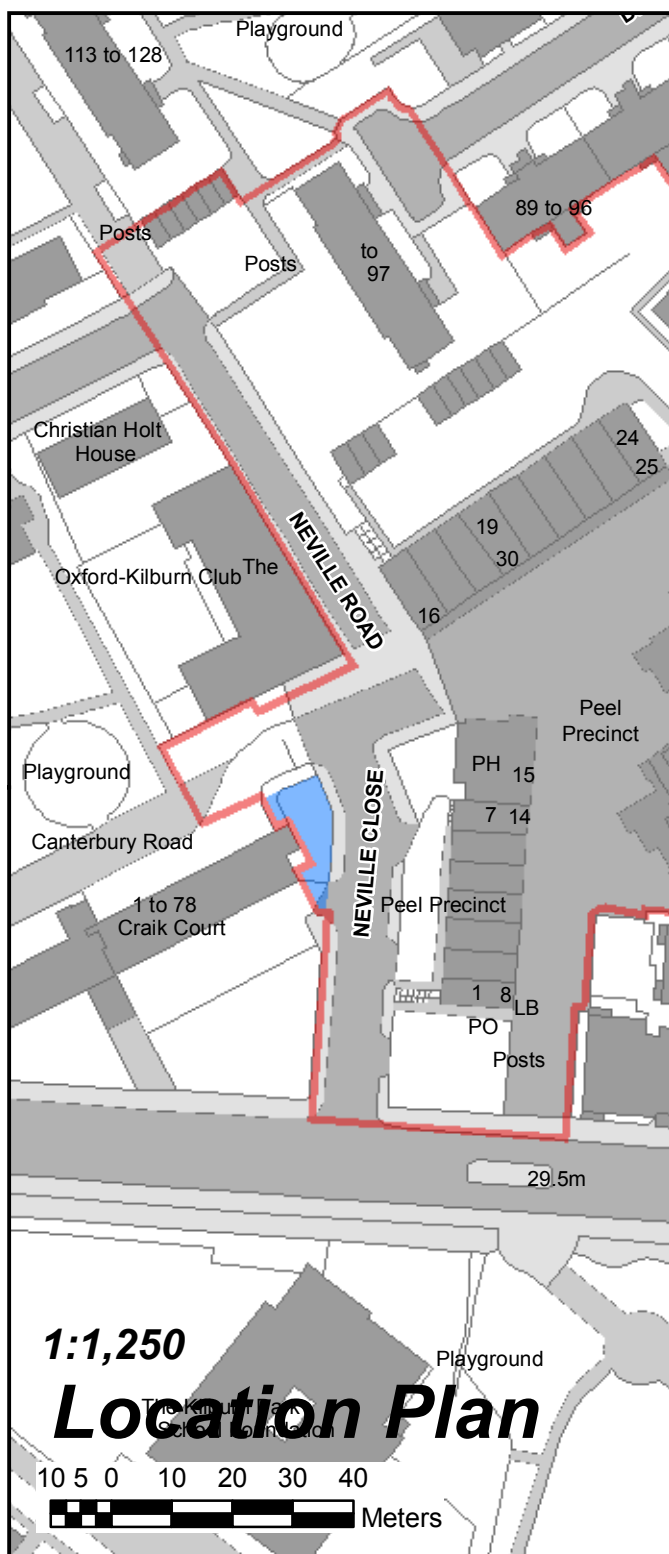

Red Line Boundary



Land Added



Land Removed



Brent

Plan to stated scale if printed at A4.

PSMA OS copyright statement

© Crown copyright and database rights 2018 Ordnance Survey 100025260

OS Open data copyright statement:

Contains Ordnance Survey data © Crown copyright and database right 2018

NORTH

