


IMPORTANT NOTE
 The specification is to be read in conjunction with the drawings and shall prevail in the event of any discrepancy. All work is to be carried out to the local Authority Planning and Building Regulations Standards as necessary. All dimensions, levels, sizes, positions and locations of particulars as indicated on drawings are to be verified by the appointed Contractor and confirmed in writing by the Architect/Surveyor/Engineer or responsible person's immediately. The Client/Building Owner must obtain any necessary consent from the relevant authorities before commencing any work on site.

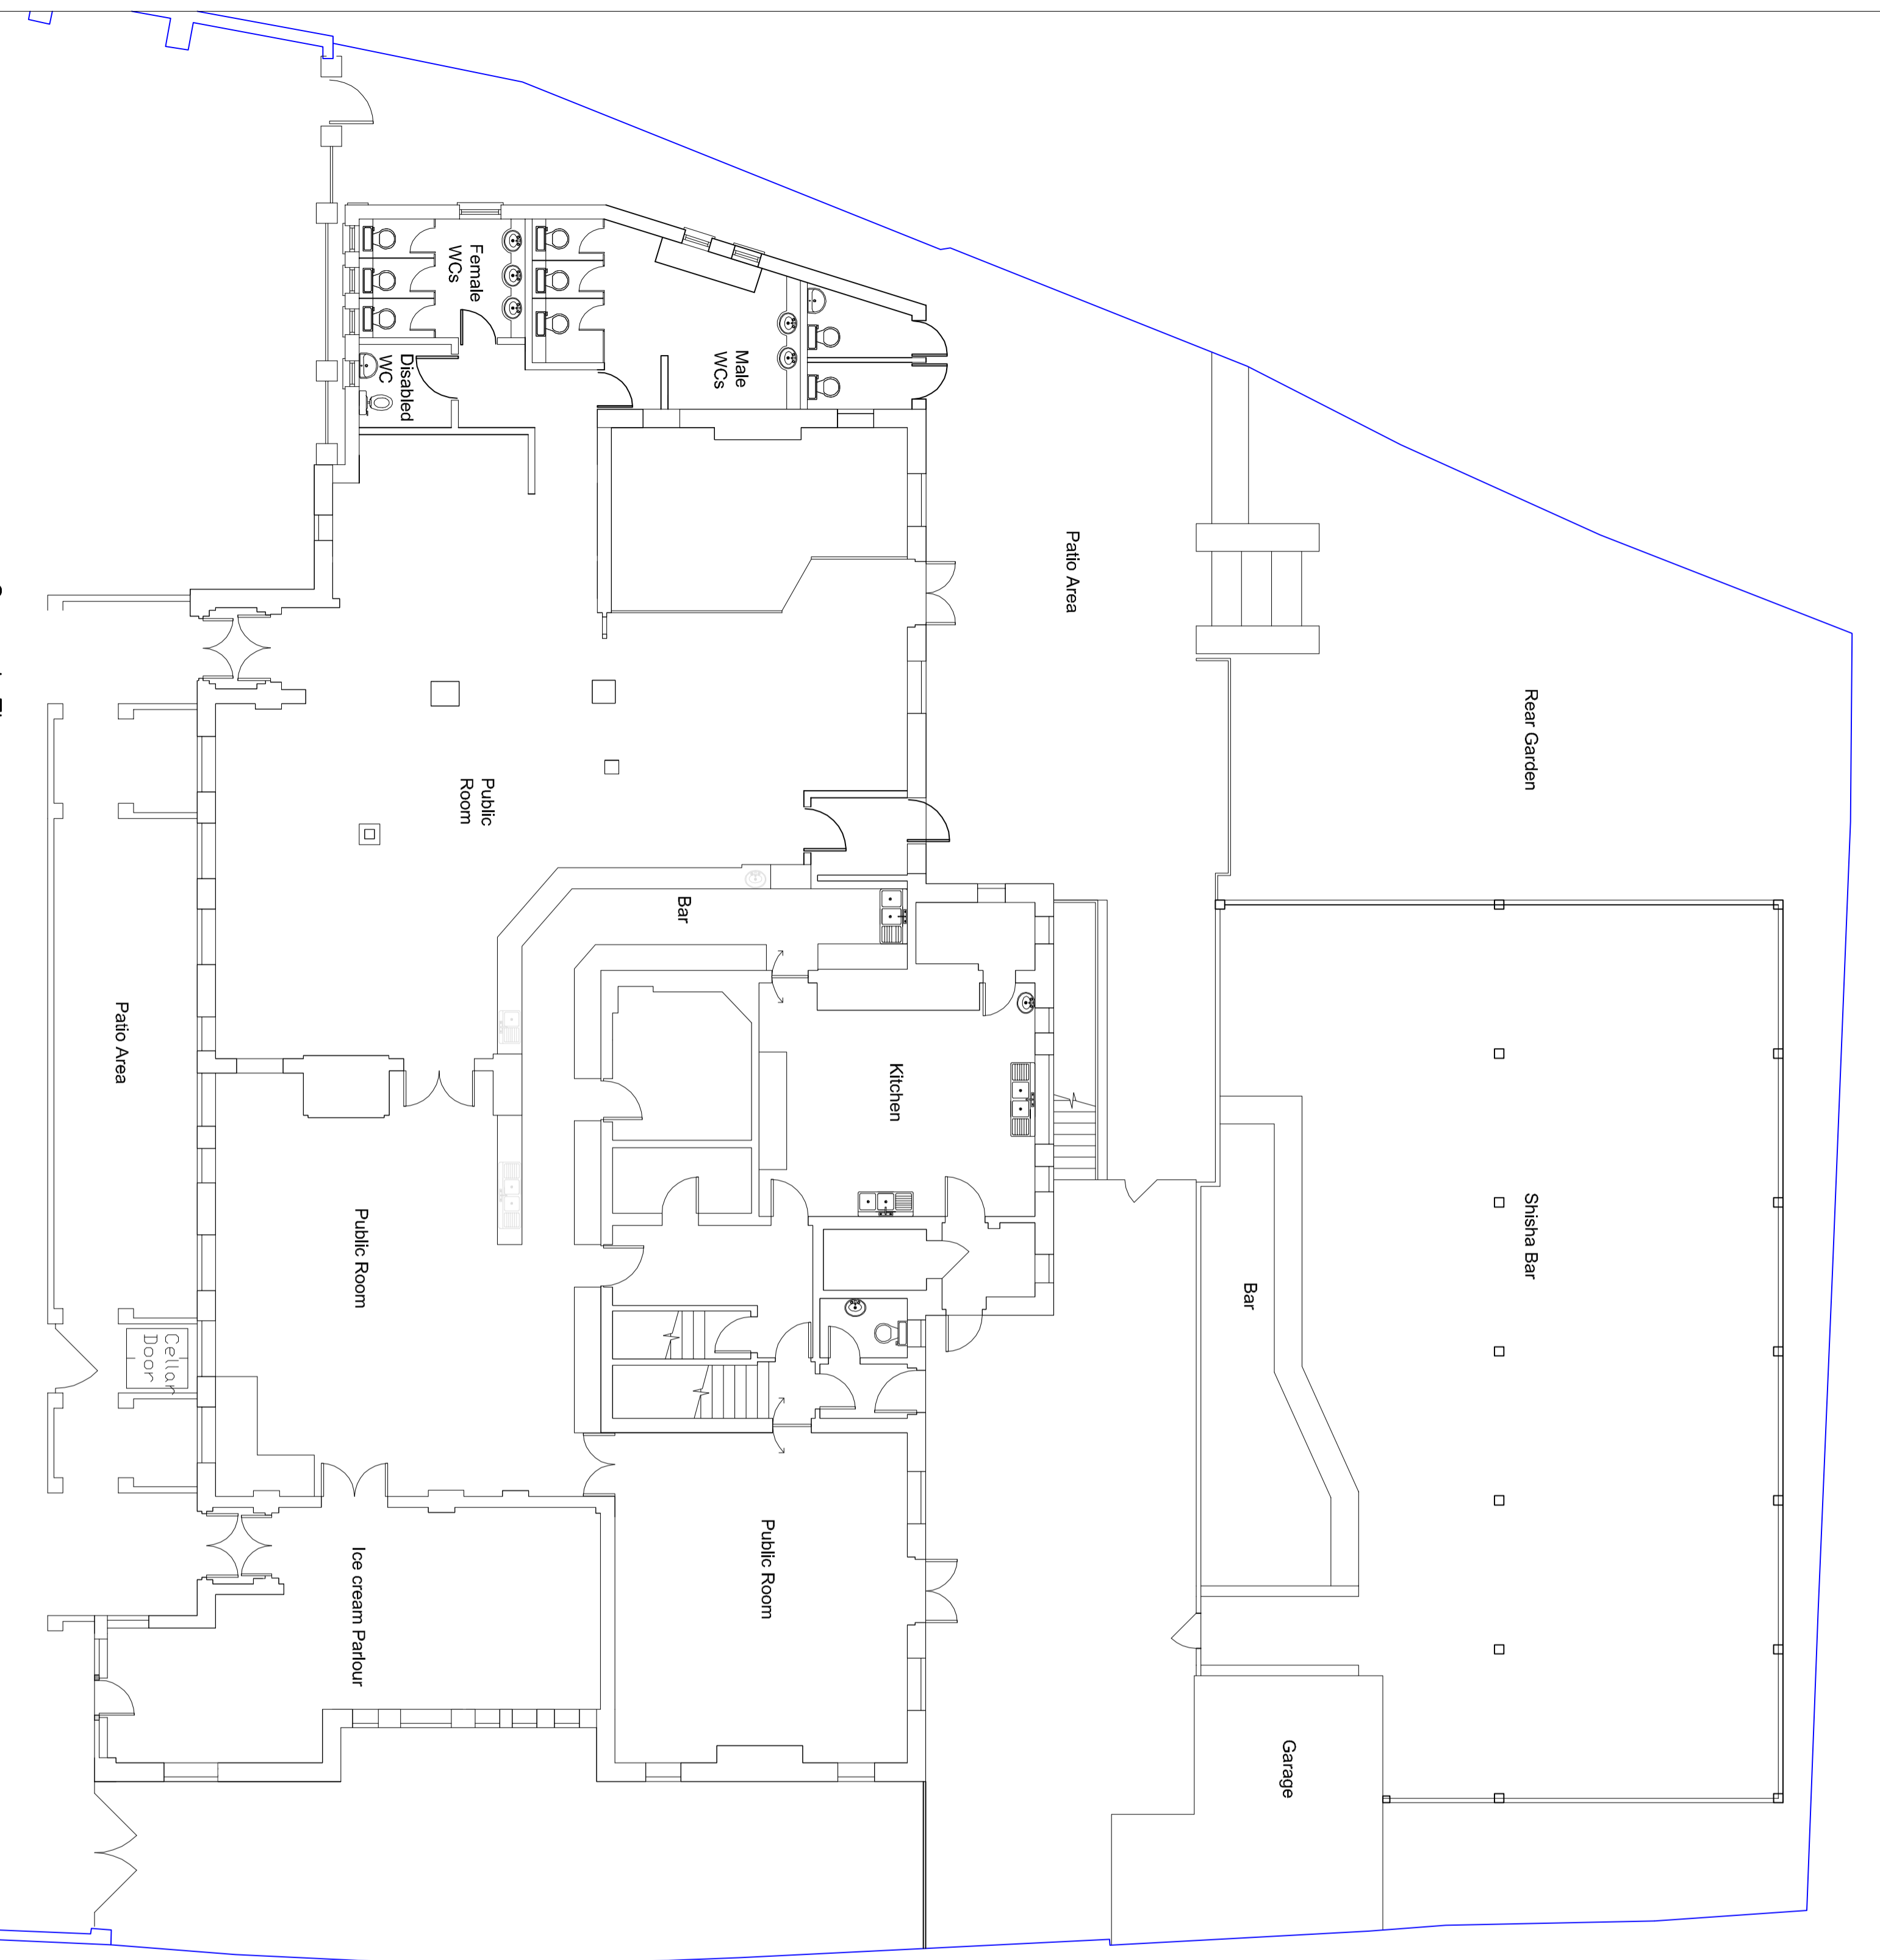

**EXISTING
 SUB-STATION**

Client	M/R N LUKKA
Site Address	THE HONEYPOT HONEYPOT LANE STANMORE HA7 7EF
Project Title	AS BUILT
Scale	
Drawn	LV
Checked	KB
Date	28.08.2013
Scale	1:100 @ A2 1:200 @ A4
Drawing Title	EXISTING GROUND FLOOR PLAN
DWG No	HONEYPOT
Drawing No	PP-01
Rev	