


Ground Floor

EXISTING
SUB-STATION

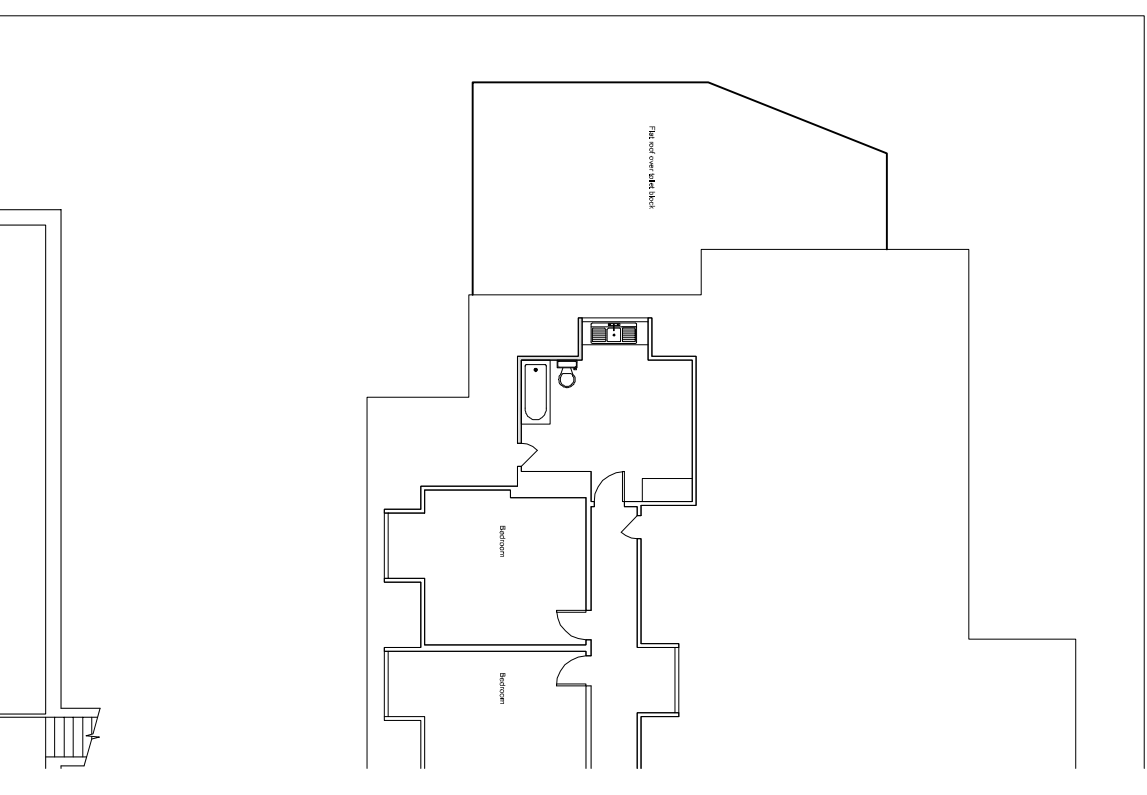

Rev.	Date	Comment
1		
2		

Client: HONEYPOT PH
 Site Address: THE HONEYPOT
 HONEYPOT LANE
 STANMORE
 HA7 1EF
 Project Title: AS BUILT

Status:
 Drawn: LV Checked: KB
 Date: 28.08.2013 Scale: 1:200 @ A3

Drawing Title: EXISTING GROUND AND
 CELLAR FLOOR PLANS

Job No	Drawing No	Rev
HONEYPOT	PP-01	