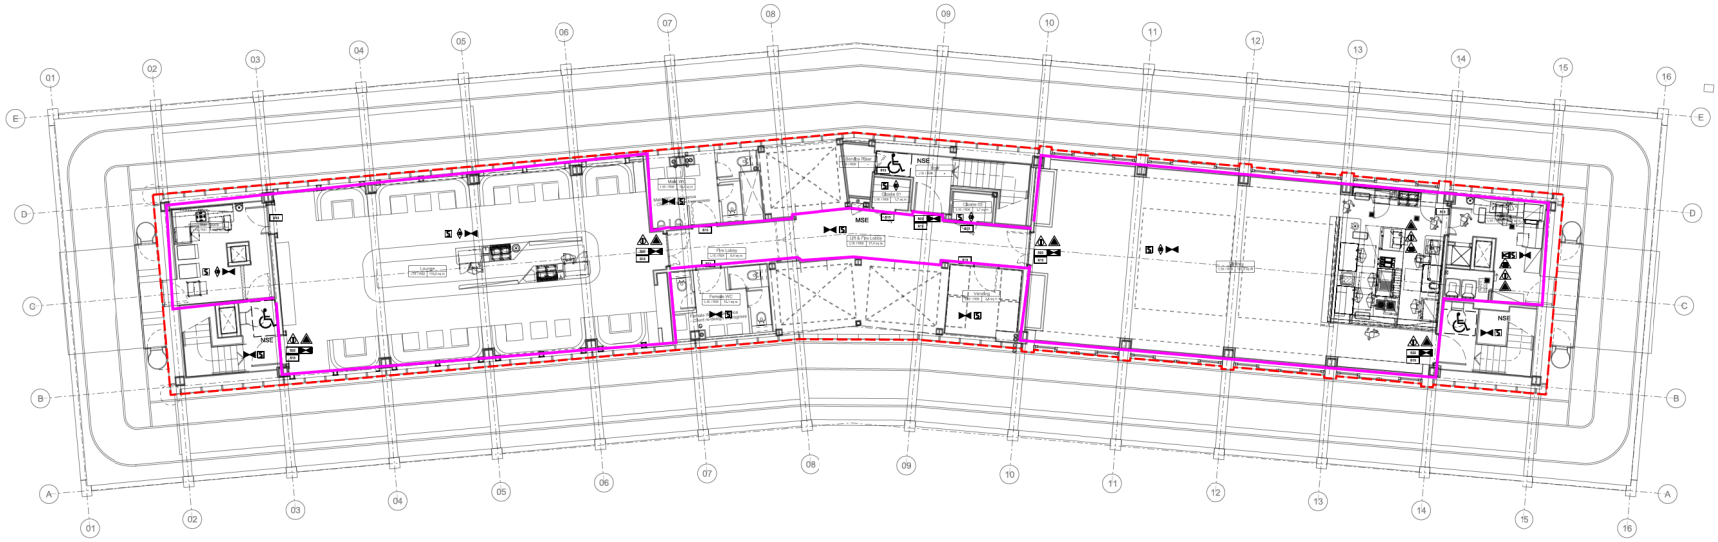

Key:

- Fire Resisting Partition / Compartment Line
- Fire Exit Sign
- Fire Exit Sign, Internally Illuminated
- Fire Door Keep Shut Sign
- Area covered by Automatic Smoke Detection
- Area covered by Automatic Heat Detection
- Area covered by Automatic Sprinkler Installation
- Area covered by Escape Lighting System
- MSE — Area covered by Mechanical Smoke Extract System
- NSE — Area covered by Passive Natural Smoke Extract System
- Water Fire Extinguisher
- Carbon Dioxide Fire Extinguisher
- Fire Blanket in container

General Notes:

Do no scale from this drawing. Use marked dimensions only.
Should any discrepancies be noted, please inform this office immediately.
This drawing is copyright of Matthew Allchurch Architects Limited

ISO 9001
Certificate No. GB2005290

Licensable Activities

Rev:	Description:	Date:	Drwn	Chkd
C	Vending area introduced - WC's omitted	09/09/20	GS	GS
B	Updated in line with Fire Engineers comments	21/07/20	GS	GS
A	Issued for Comment	24/06/20	GS	GS

Scale: 0m 1 2.5 5 10m

the boathouse design studio
27 ferry road teddington tw11 9nn
t: 020 8973 0050
e: info@maa-architects.com
w: www.maa-architects.com

Client:
Dukelease Ltd

Project Name:
York House, Empire Way, Wembley

Drawing Title:
Licensing Plans
Level 16

Drawing Status:	Status Code:	Project No:	Scale at A1:
Comment		DKL01	1:100
Drawing No:	**Revision:**	**Date:**	**Scale at A3:**
DKL01_571_304	C	24.06.20	1:200